
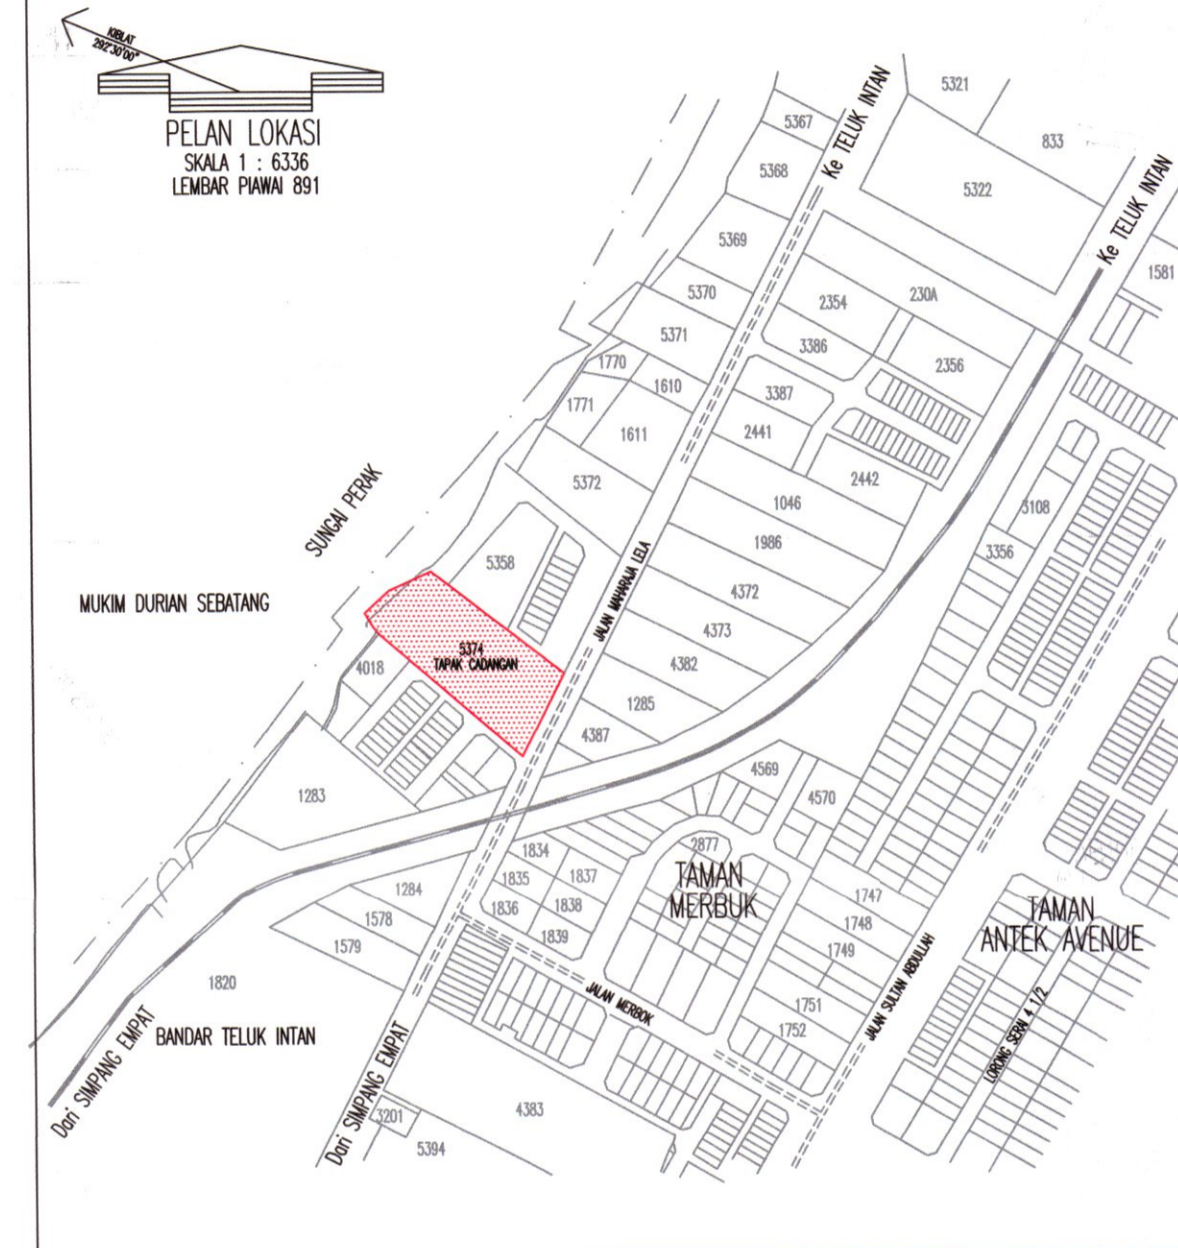


PELAN TAPAK
SKALA : 1 : 1000
NO. SYT : 891

LUKISAN TELAH DISEMAK
ULASAN: *OK*
TARIKH: 11/12/2024

Lukisan ini hanya boleh digunakan dalam tempoh setahun daripada tarikh kelulusan 11/12/2024

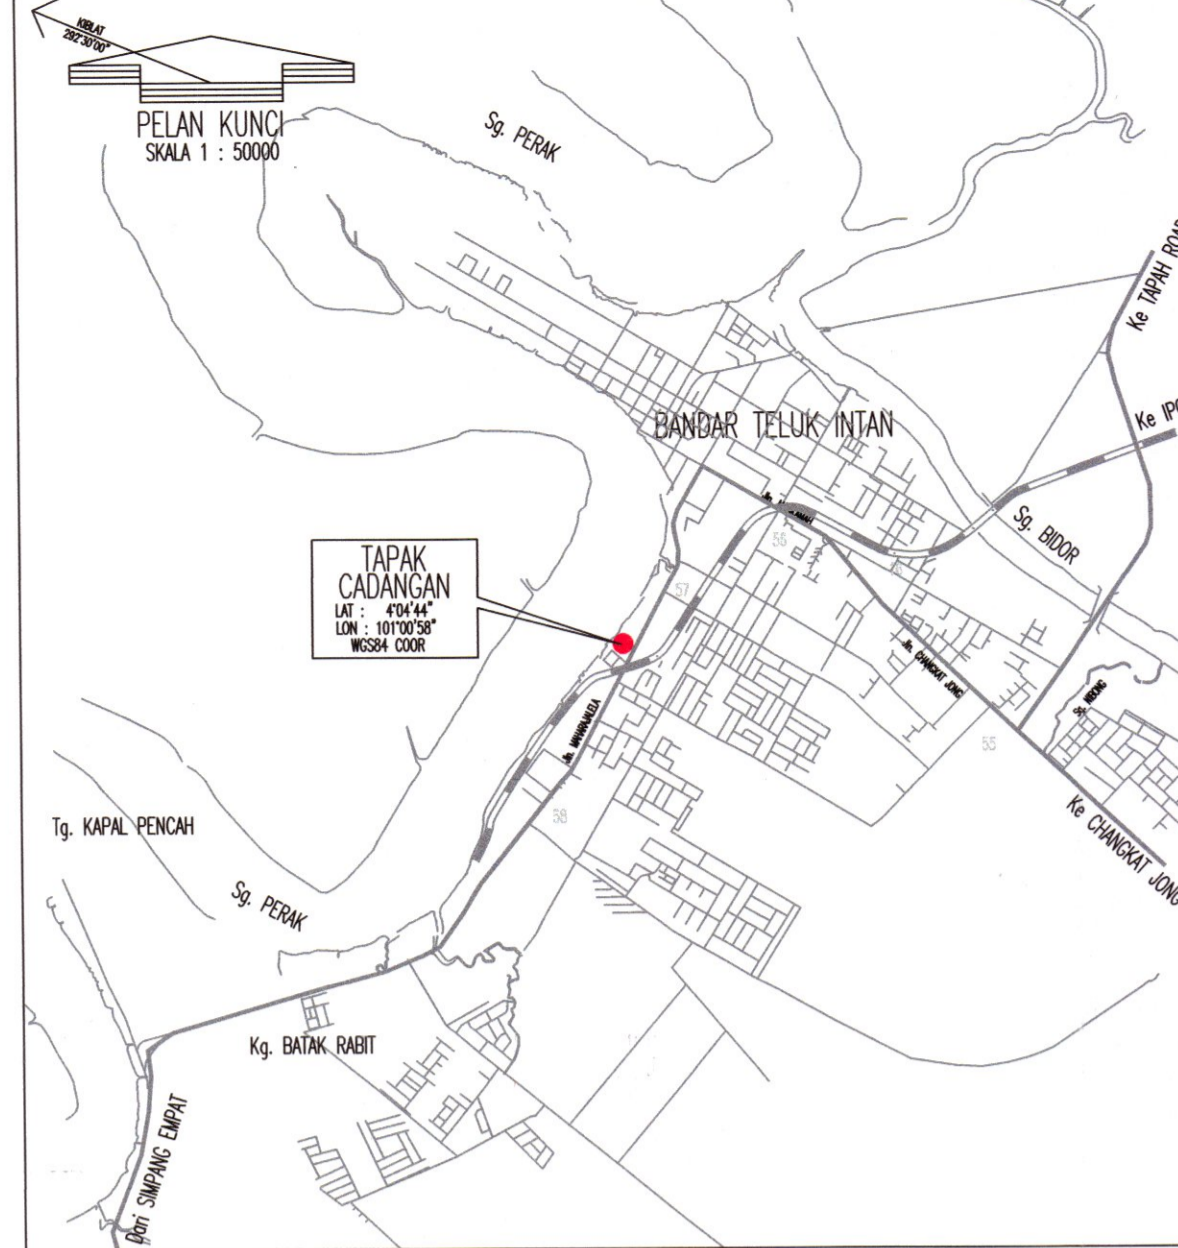

- TECHNICAL INFORMATION**
- LYCOPOLITE COLUMN DESIGN CONFORMS TO BE BS 5649.
 - BASIC WIND SPEED - 35 m/s.
 - OTHER STEEL ACCESSORIES CONFORMS TO BS 360.
 - COLUMN SEAM WELDING CONFORMS TO BS 5135, 1985 BY AUTOMATIC CONTINUOUS WELDING PROCESS.
 - COLUMN ARE HOT-DIP GALVANIZED TO BS 729 WITH MINIMUM AVERAGE COATING WEIGHT OF 460 gm/m² FOR ANY INDIVIDUAL TEST AREA.
 - ALL DIMENSIONS IN mm UNLESS INDICATED OTHERWISE.
 - QUALITY CONTROL PROCEDURE: THE SUPPLIER/MANUFACTURER AND GALVANIZER OF THE COLUMN SHALL BE ISO 9000 : 94 ACCREDITED.

- NOTA**
- PEMANGKAPAN LAMPU JALAN HENDAKLAH DIKURANGKAN OLEH TUBA PEMBORONG ELEKTRIK YANG DILULUSKAN OLEH TNB.
 - PENGANGKAPAN PEMANGKAPAN KABEL-KABEL HENDAKLAH DI BAHAWA TNB.
 - TALAN UMBANG TIDAK MENGANGGUSI LALUAN.
 - SEMUA PERALATAN DARIPADA SEPERTI 'BRACKET' ATAU 'CHOKE' HENDAKLAH DIGALVAN.
 - LANTERN LAMPU HENDAKLAH DARI JENAMA YANG DILULUSKAN OLEH AGENSI KEKWA.
 - PEMBORONG ELEKTRIK KERJA YANG MEMANGKAPAN LAMPU JALAN HENDAKLAH MEMAKAIKAN BORANG PERMOHONAN KEPADA TNB TERLEBIH DAHULU.
 - BILANGAN DAN LOKASI PETI METER TNB HENDAKLAH DI TAPAKAN OLEH PAK TNB.
 - PAP G.I. (GALVANISED IRON) HENDAKLAH DIGUNAKAN BAGI PAP KABEL YANG MELINTASI LONGKANG.

- LEGEND:-**
- EXISTING TNB POLE
 - EXISTING TM POLE
 - EXISTING LAMP POLE
 - PROPOSED 200W LED STREET LIGHTING MOUNTED ON ARM-LESS 10M HEIGHT GALVANISED POLE. [7 Nos.]
 - PROPOSED JKR FEEDER PILLAR
 - PROPOSED TNB METER KIOSK
 - PROPOSED 4" Ø PN10 PIPE ROAD CROSSING
 - PROPOSED STREET LIGHTING CABLE ROUTE (UNDERGROUND) 14x4x16mm²
 - PVC/SWA/PVC AL LAD UNDERGROUND

GENERAL NOTE:
ALL DIMENSION HAS TO BE VERIFIED AND CONFIRMED ON SITE. ANY DISCREPANCY HAS TO BE REPORTED TO THE PERSON IN-CHARGE BEFORE PROCEEDING WITH ANY CONSTRUCTION.

ITEM	DATE	AMENDMENT

OWNER'S SIGNATURE :

CHONG SANG ONN SON BHD (50335-T)
NO. 237, JALAN INTAN 10, BANDAR BARU TELUK INTAN,
36000 TELUK INTAN, PERAK.
TEL: 05-622 1985 EMAIL: chongsangonn@gmail.com

PROJECT :
PERMOHONAN LAMPU JALAN BAGI CADANGAN SKM PERMAGAN DI ATAS LOT 5374, BANDAR TELUK INTAN, DAERAH HILIR PERAK, PERAK DARUL RIJAZAH UNLUT
TUJUAN CHONG SANG ONN SON BHD

TITLE :
PELAN TAPAK, KUNCI DAN LOKASI
PELAN LAMPU JALAN

ENGINEER'S SIGNATURE :
MOKHTAR CONSULT & ASSOCIATES
CIVIL, STRUCTURAL, MECHANICAL & ELECTRICAL CONSULTING ENGINEERS
9A-11A, JALAN CHENG THYE PHIN, 30250 IPOH,
PERAK DARUL RIJAZAH
TEL : 05-5414188, 05-2535775 FAX : 05-2544270
E-MAIL : mck@mcma.com.my
E-MAIL 2 : mokhtarconsult@gmail.com

COPYRIGHT (C) OF MOKHTAR CONSULT & ASSOCIATES
ALL RIGHTS RESERVED.
THIS DRAWING IS COPYRIGHT EXCEPT FOR THE CONSTRUCTIONS OF THE PROJECT NAMED HEREIN.
NO PART OF THIS DRAWING SHOULD BE REPRODUCED BY ANY MEANS NOR TRANSMITTED IN TO
MACHINE LANGUAGE OR USE FOR THE CONSTRUCTIONS OF OTHER PROJECTS DIFFERENT FROM
THAT NAMED HEREIN WITHOUT THE WRITTEN PERMISSIONS OF MOKHTAR CONSULT & ASSOCIATES.

SUBMISSION DRAWING TENDER DRAWING AS BUILT DRAWING
 PRELIMINARY DRAWING CONSTRUCTION DRAWING APPROVED FOR ISSUANCE
 SCALE : AS SHOWN CHECKED BY : Ir. CHENG KOK JOR DRAWN BY : ADLINA
 DATE : 2/12/2024 APPROVED BY : Ir. CHENG KOK JOR
 A/CAD FILE : [2.12.24] SUN NOON REALTY_CSO - SITE(JKR-SL) REV1.dwg
 DRAWING NO. : CKJ/MCA/6168/17/JKR-SL-1

MOUNTING HEIGHT 'H' (m)	DOOR OPENING 'L' x 'W' (mm)	DOOR OPENING FROM GROUND 'C' (mm)	TYPE OF POLE FLANGED			J-BOLT 'J' (mm)
			D	E	F	
10	450 X 120	600	355	260	30 x 65	#25mm 560mm - 600mm LENGTH
11	450 X 120	600	355	260	30 x 65	
12	450 X 120	600	400	300	30 x 65	

TIANG LAMPU JALAN DI CAT DENGAN CAT ANTI STIKER DENGAN KETINGGIAN 2.5M DARI PERMUKAAN TAPAK TIANG

ARM LENGTH 'L'

1.0m	1.5m	2.0m	2.5m	3.0m
------	------	------	------	------

