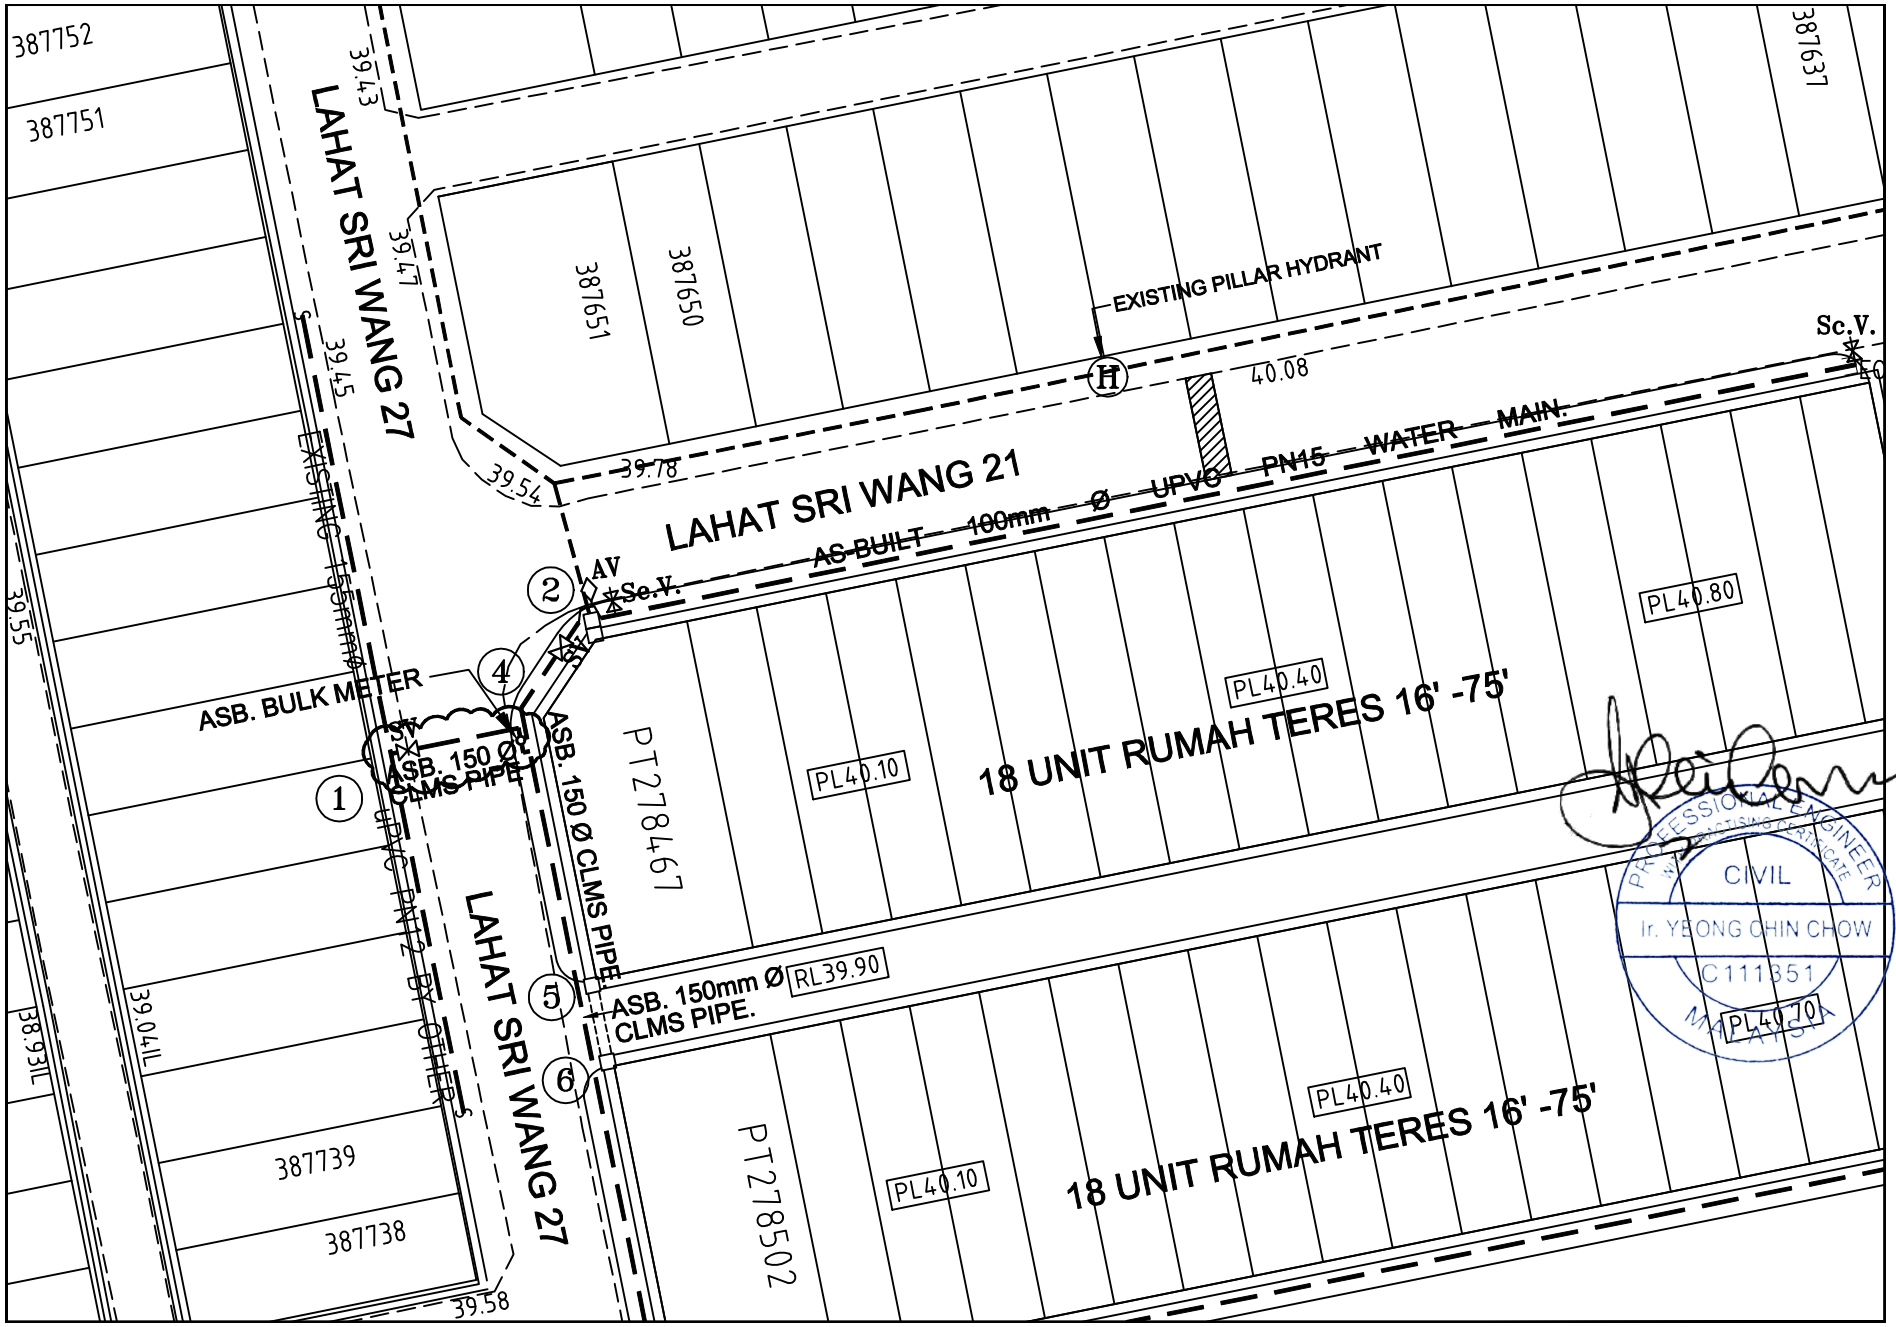
387752
387751
387637
387651
387650
LAHAT SRI WANG 27
LAHAT SRI WANG 21
EXISTING PILLAR HYDRANT
Sc.V.
40.08
39.43
39.47
39.45
39.54
39.78
39.55
39.041L
38.93IL
39.58
EXISTING 150mmØ UPVC PN12 BY OTHERS
AS BUILT 100mm Ø UPVC PN15 WATER MAIN.
AV
Sc.V.
ASB. BULK METER
ASB. 150 Ø CLMS PIPE
ASB. 150 Ø CLMS PIPE
ASB. 150mm Ø CLMS PIPE.
PT278467
PT278502
PL40.80
PL40.40
PL40.10
PL40.70
RL39.90
18 UNIT RUMAH TERES 16' -75'
18 UNIT RUMAH TERES 16' -75'
387739
387738
PROFESSIONAL ENGINEER
CIVIL
Ir. YEONG CHIN CHOW
C111351
MALAYSIA