

## TECHNICAL PROPOSAL

e TP Number : TP250828047  
 Project Name : Proposed to upgrade from overhead to underground infrastructure for CPCS Link (Trong - Kuala Kurau)  
 Area 1  
 Location : Trong – Kuala Kurau  
 GPS Coordinate : 4.697150° 100.695266°  
 Contractor : Purnama Solution Sdn Bhd  
 Survey Date : 03/09/2025



## TABLE OF CONTENT

	<b>PAGE</b>
<b>1.0 TP CHECKLIST</b>	3
<b>2.0 GENERAL INFORMATION</b>	4
<b>3.0 CONSTRUCTION DETAILS</b>	5
<b>4.0 PROPOSAL FOR FIXED NETWORK ACCESS</b>	6
4.1    INTRODUCTION	7
4.2    TRENCHING	7
4.3    CABLING & DUCTING	7
4.4    LOCATION MAP (WITH GPS COORDINATE)	8
<b>5.0 APPENDIX A</b>	9
5.1    PRODUCT PORTFOLIO	9
5.2    DRAWING – SPUR CIVIL	10
5.3    DRAWING – SPUR SLD 144C	11
<b>6.0 APPENDIX B</b>	
6.1    SITE PHOTOS FOR RESIDENCE	12
6.2    POLE and MH COORDINATES	22



## 1.0 TP CHECKLIST

No	Description	YES	NO	Remarks
1	TDC existing POLE coordinate	✓		Lat: 4.710168° Long: 100.717950°
2	Existing premises area manhole coordinate	✓		
3	Any Gas pipe signage seen at site? If YES, attach photo.		✓	
4	Any TNB cable signage seen at site? If YES, attach photo		✓	
5	Any crossing drainage? If YES, attach photo & width of the drainage	✓		
6	Any INDAH WATER manhole seen at site? If YES, attach photo		✓	
7	Any crossing traffic light? If YES, attach photo & measurement of the traffic light box		✓	
8	Has identified related Local Authority? Kindly indicate.	✓		JKR (LARUT, MATANG AND SELAMA
9	Drawing for outside plant (OSP) survey – Residential area & civil work up to last TIME manhole (.dwg format - AutoCAD & .pdf format) *	✓		
10	Prepare the complete 1 copy of Technical Proposal (.pdf format & Power point) –of softcopy – 1 copy	✓		
11	Bill of Quantity for civil, fibre pulling, splicing & termination	✓		
12	The latitude & longitude of the residential area and last TIME manhole in 6 decimal points (xx.xxxxxx, x.xxxxxx) in TP Location Map.	✓		
13	Open up the manhole at any spot of joint/ring cut & provide duct space record for this project (photo required). Please make sure that there is TIME cable in the manhole (photo required). <b>If unable to open up the manhole, photo of manhole surrounding is required.</b>		✓	Manhole in the side of the road
14	Survey Acknowledgement Form signed & attached.	✓		
15	Others		✓	



## 2.0 GENERAL INFORMATION

Prepared by : Purnama Solutions (M) Sdn Bhd

***Date of LOI :***

Date of Survey : 04/09/2025

Surveyed by : Purnama Solutions (M) Sdn Bhd

Drawing Prepared by: Purnama Solutions (M) Sdn Bhd

Eng. Person In charge :

**General Information**

Site Name : Link TRONA - KKURA

Full Address : Trong - Kuala Kurau

Type of Development : SPUR

No of Unit : NA

No of unit per row/block : NA

No of row/block per Dev : NA

**Contact Person**

**Management / Dev  
Comittee**

Name: NA H/P NA

Designation: Tel

Email Address: NA

**Maintenance / Security  
Department**

Name: Designation: Email NA H/P Tel NA

Address: NA

-

**Comments**

**For TimeDotComBhd Use Only**

Remarks



### 3.0 CONSTRUCTION DETAILS

No.	Description	Method	Distance (m) / units
1.	Total Civil	HDD 1W	3265m
		OC 1W	20m
2.	Total Fiber Pulling 144C	UG	Approx 3382m
3.	Others	JRC7	17 units
		GI 1W	12m

**Comment :**

For Contractor Use Only :

Based on our detail survey, evaluation study and due diligent conducted, we strongly proposed the above stated technical details to be implemented at this site.

For Client Use Only :



## **4.0 PROPOSAL FOR FIXED NETWORK ACCESS**

### **4.1 Introduction**

- 4.1.1 TIME dot Com (TTdC) offers a wide variety of fixed-line telecommunications services. As part of its commitment to provide the customers with the best possible solutions to serve all their communications needs ; TTdC aim to enhance telecommunication services in this residential area to offer the residents with High Speed Internet, Data and Voice connectivity. This residential area will be enhanced today for tomorrow's communication and IT requirements. With that, TTdC provide a choice of Service Providers to the residents and gain a future-proof communication infrastructure.
- 4.1.2 A physical infrastructure link to this residential area is the main access to deliver services to the residents. The typical link required is through fiber optic cable.
- 4.1.3 In order to support the services, TTdC require an access to certain related infrastructure facility in order to provide services to the end user (resident).
- 4.1.4 To be able to deliver these services to the residential area, TTdC will pull its own fiber optic cables from the nearest hub and place its access equipment's at certain identified location in the area. In order to reach each of the resident premises (houses), TTdC will lay the required fiber optic cable and drop close to the premises.
- 4.1.5 With this setup we will have TTdC connection right up to each of the resident premises/houses in this residential area.

### **4.2 Trenching**


- 4.2.1 The propose trenching route will be implemented in certain identified route situation that are not connected. The purpose is for laying fiber cable along the trenching route to upgrade overhead to underground civil infrastructure for CPCS link Trong-Kuala Kurau.
- 4.2.2 The permission to trench is under the identified local authority jurisdiction and to be applied separately if necessary.
- 4.2.3 This proposal is based on assumption that there is fiber cable to be connected in the existing TIME manhole.



### **4.3 Cabling and Ducting**

- 4.3.1 TDC will propose new duct to pull new 144C optical fiber cable from existing TTdC pole to the proposed TTdC manhole via propose new route.
  
- 4.3.2 In near future, TIME dot Com also like to propose to pull optical fiber cable for GPON services that require optical interface equipment up to customer.

#### 4.4 LOCATION MAP (WITH GPS COORDINATE)

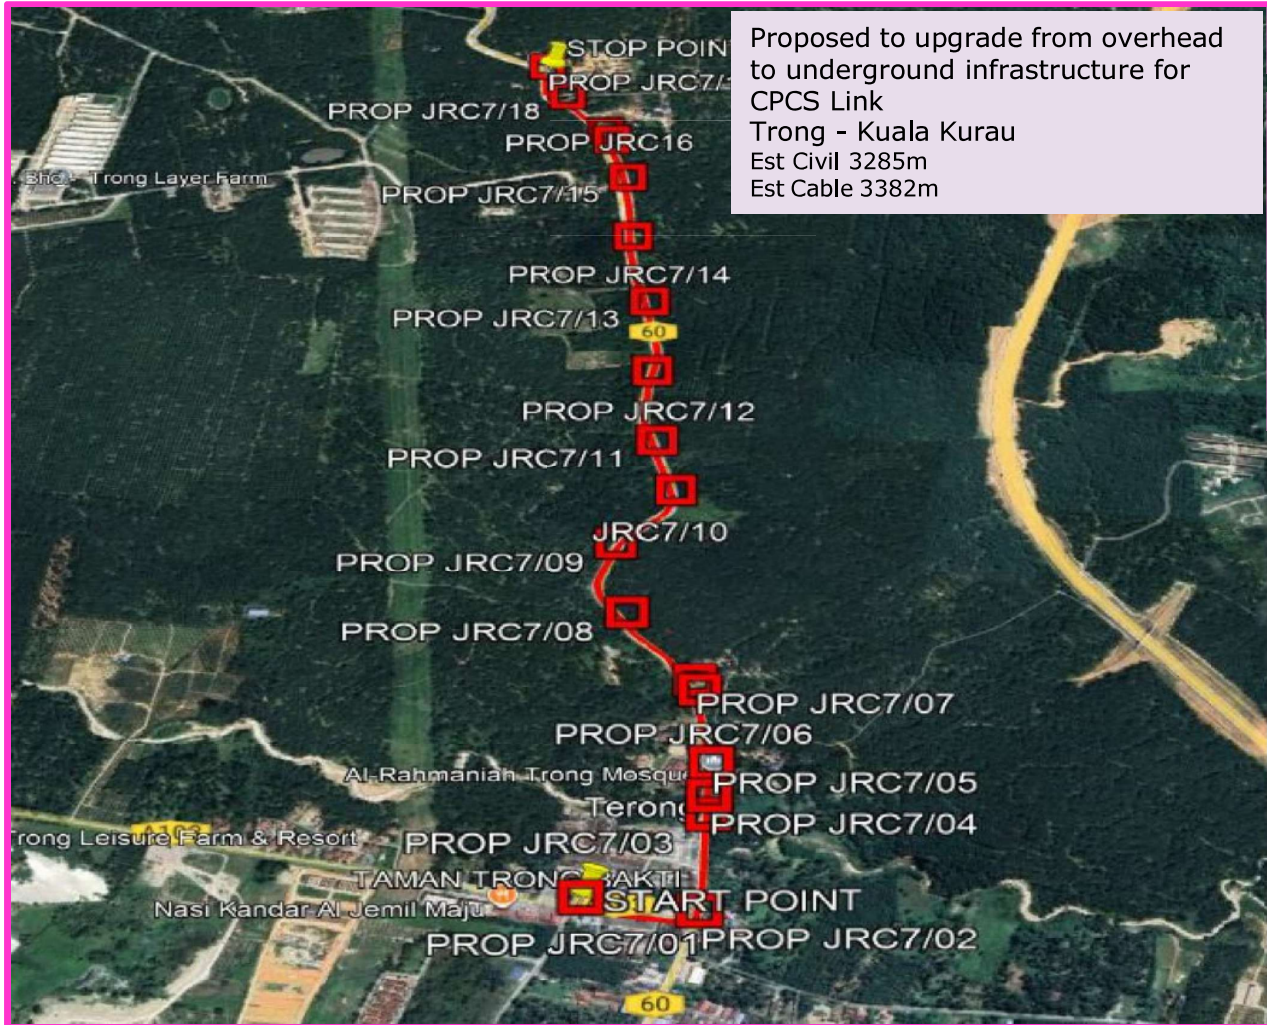

**Proposed to upgrade from overhead to underground infrastructure for CPCS Link (Trong - Kuala Kurau) Area 1**

**4.697150° 100.695266°**



## 5. APPENDIX A

### 5.1 Product Portfolio

TIME DOT COM CONNECTIONS FOR COMMERCIAL	
<b>Private Data Network</b>	<p>Our Virtual Private Network (VPN) is designed to deliver you an efficient, secured and reliable service. We provide point-to-point technology that directly connects you to your clients and employees. We ensure complete privacy and security, while at the same time, maximizing your speed and bandwidth;</p> <ul style="list-style-type: none"><li>⇒ Channelized Leased Circuit</li><li>⇒ Ethernet Leased Circuit</li><li>⇒ International Private Leased</li><li>⇒ Circuit (IPLC)</li><li>⇒ Metro LAN</li><li>⇒ International Ethernet Private Leased Circuit (IEPLC)</li></ul>
<b>Internet</b>	<p>TIME Internet services allow you to connect to the world speedily with high scalability, reliability and security. Choose the best solution that suits your need and TIME will take care of the rest;</p> <ul style="list-style-type: none"><li>⇒ Channelized Direct</li><li>⇒ Ethernet Direct</li><li>⇒ Business Broadband</li><li>⇒ Satellite Broadband</li><li>⇒ Home Broadband</li></ul>
<b>Voice</b>	<p>We've got a wide range of services from basic phone line with crystal clear voice quality to our account based postpaid Virtual Call service. We also provide local and International toll free services, and even business or individual calling cards. With TIME, it's so easy to stay in touch;</p> <ul style="list-style-type: none"><li>⇒ Business Voice Line</li><li>⇒ ISDN PRI</li><li>⇒ International Toll Free</li><li>⇒ Toll Free 1300</li><li>⇒ Toll Free 1800</li><li>⇒ Audio Conferencing</li><li>⇒ Home Fixed Line</li></ul>
<b>Managed Services</b>	<p>TIME Managed Services deliver end-to-end networking solutions. Focus on your productivity while we provide you with support possible to take your business to the next level;</p> <ul style="list-style-type: none"><li>⇒ IPVPN</li><li>⇒ SAN Extension</li></ul>
<b>Wholesale Service</b>	<p>We are able to offer you unmatched capacity and network resiliency. We aim to ensure seamless connectivity and high availability, thus maximizing your operational capabilities;</p> <ul style="list-style-type: none"><li>⇒ Wholesale bandwidth</li><li>⇒ Wholesale Voice (Transit Premium, Transit CLR)</li><li>⇒ Cross Peninsular Cable System (CPCS)</li></ul>



**5.2 Drawing – Site Plan Civil**








 





 
 



**REFER TO NEXT SLIDE**




**CONFIDENTIALITY**

These drawings and details are and shall remain the property of TT dotCom Sdn Bhd. Both are issued in strict confidence and shall not be reproduced, copied or used in any manner without specific written permission from the owner.

**LEGEND :-**

-  = MDF ROOM
-  = EXISTING PIT
-  = BUILDING MANHOLE (BMH)
-  = NEW TIME MANHOLE
-  = PROJECT TIME MH BY OTHER
-  = EXISTING TIME MANHOLE (EXTG TMH)
-  = PIT
-  = EXISTING TMB MANHOLE
-  = 2W MT
-  = RIGHT OF WAY
-  = EXISTING DUCT ROUTE
-  = WORK AREA
-  = GRASS AREA
-  = TRAFFIC FLOW
-  = HORIZONTAL DIRECTIONAL DRILLING
-  = OPEN CUT
-  = MICRO TRENCHING
-  = ROAD BOUNDARY

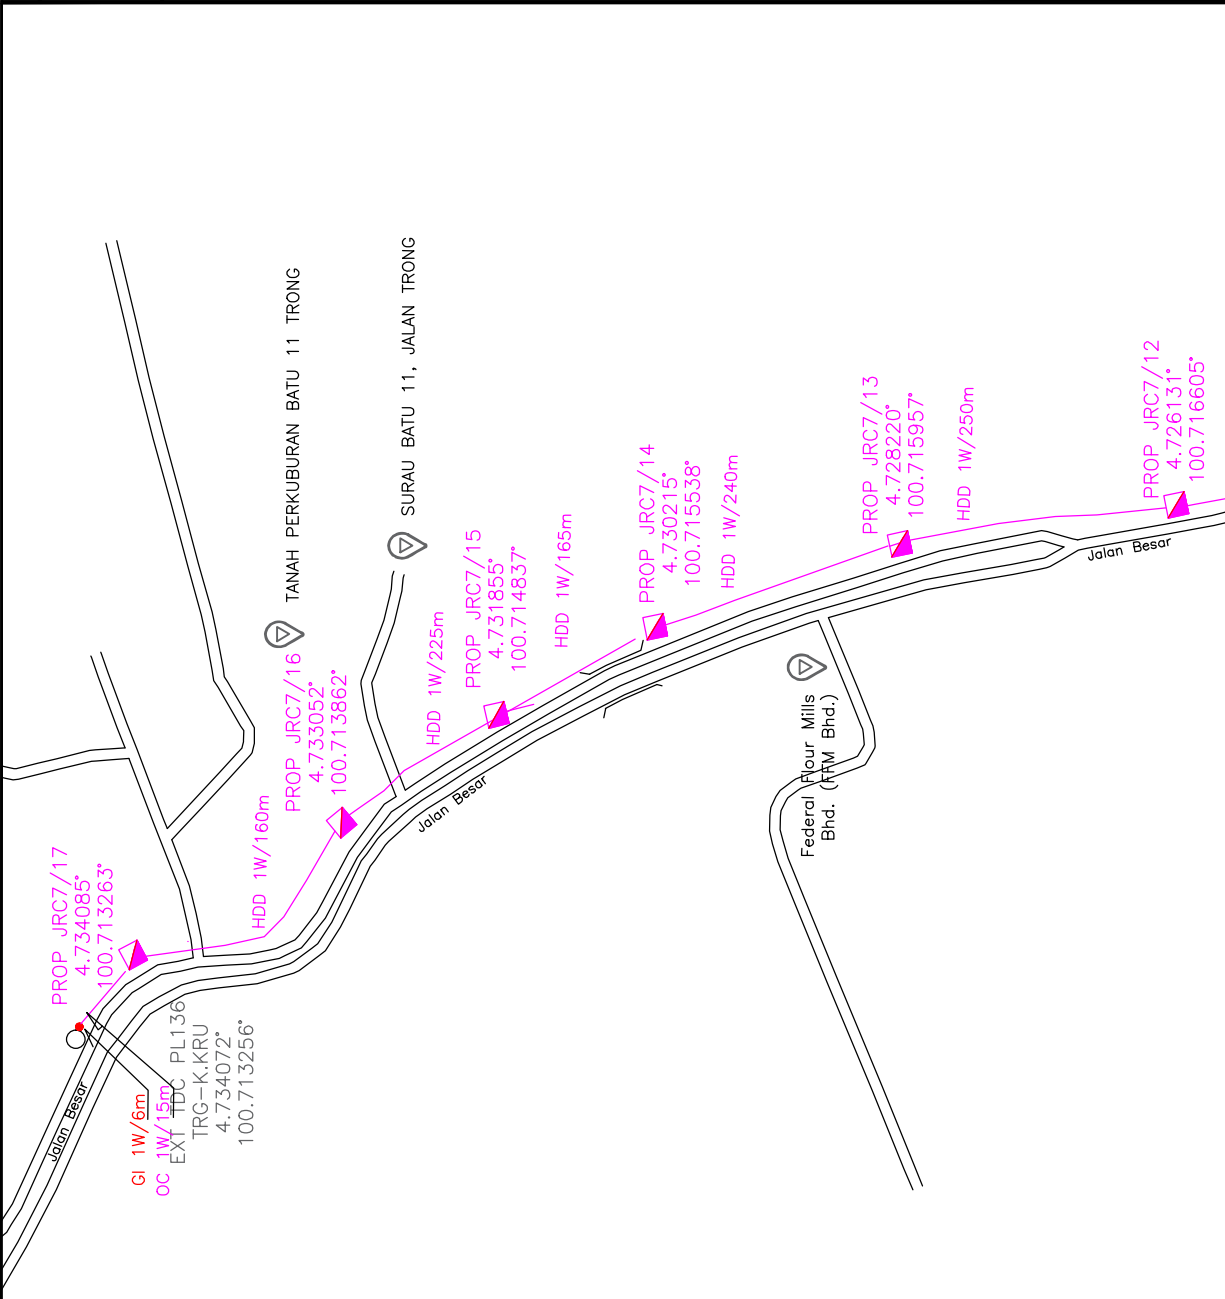

<b>DRAWING SCALE:</b> N.T.S	<b>DRAWING UNITS:</b> METER
<b>PREPARED BY:</b> NUR HIDAYAH	<b>INITIAL &amp; DATE:</b> 25/06/2025
<b>DESIGNED BY:</b> PURNAMA SOLUTION	<b>INITIAL &amp; DATE:</b> 25/06/2025
<b>CHECKED BY:</b> INDRAN	<b>INITIAL &amp; DATE:</b> 25/06/2025
<b>APPROVED BY:</b> TT DOTCOM SDN BHD	<b>INITIAL &amp; DATE:</b> 25/06/2025

**PROJECT TITLE:**  
KUALA KURAU

**DRAWING TITLE:**  
AS BUILT DRAWING – KUALA KURAU

**DRAWING NO:** TTDC/COV/ANGGUN LUMAYAN/01\_1-01 | **SHEET NO:** 1/1



**PURNAMA SOLUTION**

**PURNAMA SOLUTION (M) SDN BHD**  
(568408-P)

S-09-03, First Subang, Jalan SS15/4C,  
47500 Subang Jaya, Selangor










 





 
 



**time**


TT dotcom Sdn Bhd 197901008085 (52371-A)  
No. 14, Jalan Majistret U1/26,  
HICOM Glenmarie Industrial Park,  
40150 Shah Alam,  
Selangor Darul Ehsan, Malaysia.  
Tel: +60 3 5032 6000 Website: www.time.com.my

**CONFIDENTIALITY**

These drawings and details are and shall remain the property of TT dotCom Sdn Bhd. Both are issued in strict confidence and shall not be reproduced, copied or used in any manner without specific written permission from the owner.

**LEGEND :-**

-  = MDF ROOM
-  = EXISTING PIT
-  = BUILDING MANHOLE (BMH)
-  = NEW TIME MANHOLE
-  = PROJECT TIME MH BY OTHER
-  = EXISTING TIME MANHOLE (EXTG TMH)
-  = PIT
-  = EXISTING TMB MANHOLE
-  = 2W MT
-  = RIGHT OF WAY
-  = EXISTING DUCT ROUTE
-  = WORK AREA
-  = GRASS AREA
-  = TRAFFIC FLOW
-  = HORIZONTAL DIRECTIONAL DRILLING
-  = OPEN CUT
-  = MICRO TRENCHING
-  = ROAD BOUNDARY

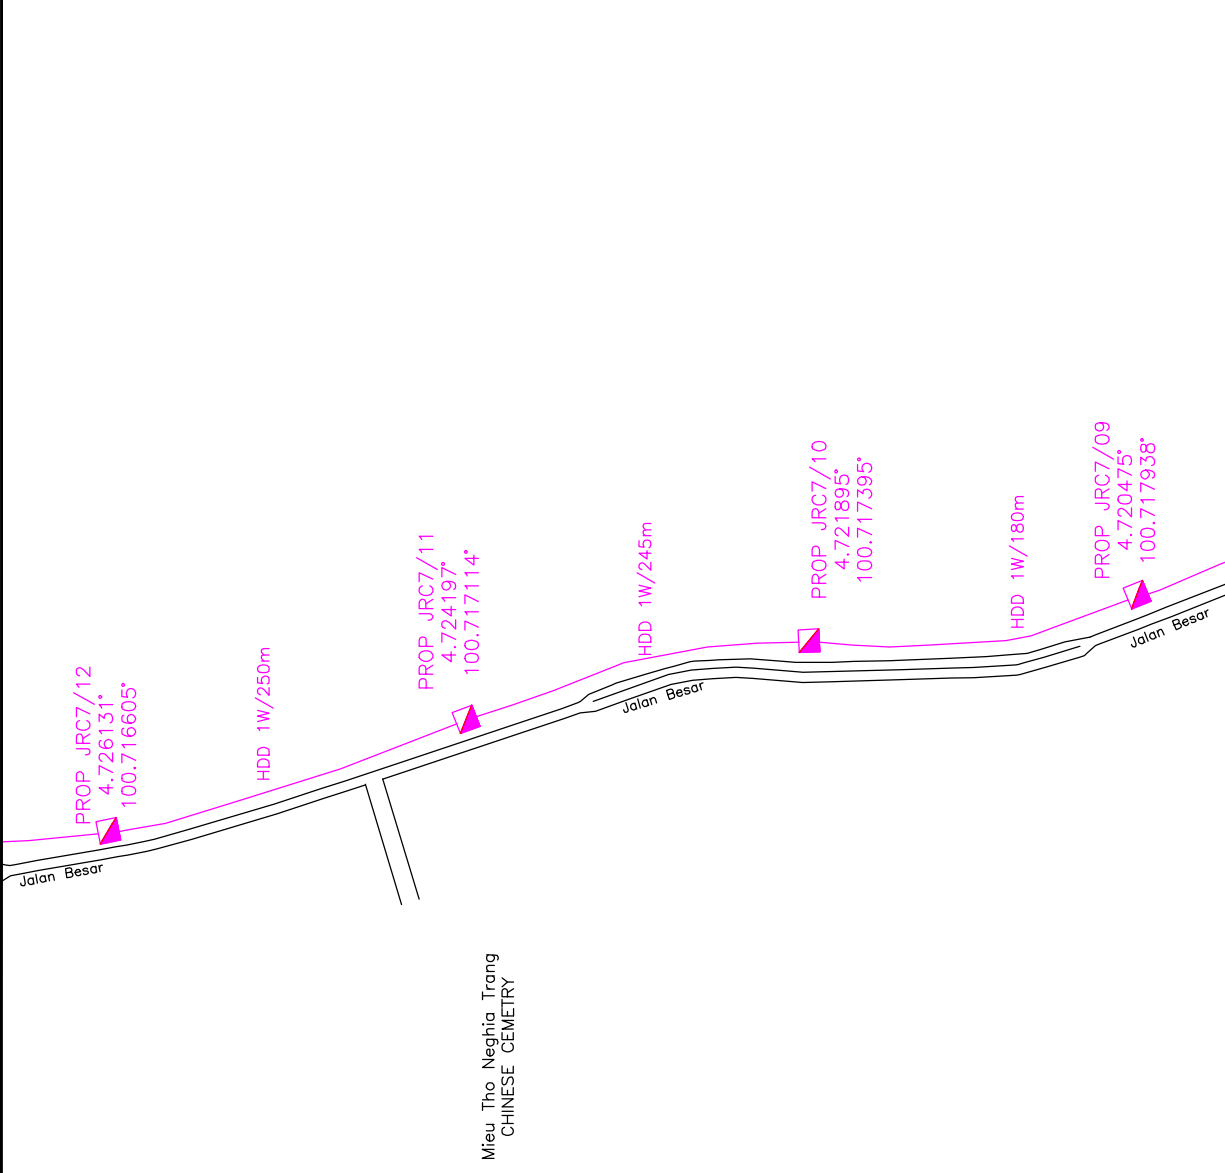

<b>PROJECT TITLE:</b>		KUALA KURAU	
<b>DRAWING TITLE:</b>		AS BUILT DRAWING – KUALA KURAU	
<b>DRAWING NO:</b>	TTDC/COV/ANGGUN LUMAYAN/01_1-01	<b>SHEET NO:</b>	1/1



TT dotcom Sdn Bhd 197901008085 (52371-A)  
 No. 14, Jalan Majistret U1/26,  
 HICOM Glenmarie Industrial Park,  
 40150 Shah Alam,  
 Selangor Darul Ehsan, Malaysia.  
 Tel: +60 3 5032 6000 Website: www.time.com.my



**PURNAMA SOLUTION**  
 (568408-P)  
 S-09-03, First Subang, Jalan SS15/4G,  
 47500 Subang Jaya, Selangor


<b>DRAWING SCALE:</b>	N.T.S	<b>DRAWING UNITS:</b>	METER
<b>PREPARED BY:</b>	NUR HIDAYAH	<b>INITIAL &amp; DATE:</b>	25/06/2025
<b>DESIGNED BY:</b>	PURNAMA SOLUTION	<b>INITIAL &amp; DATE:</b>	25/06/2025
<b>CHECKED BY:</b>	INDRAN	<b>INITIAL &amp; DATE:</b>	25/06/2025
<b>APPROVED BY:</b>	TT DOTCOM SDN BHD	<b>INITIAL &amp; DATE:</b>	25/06/2025

**CONFIDENTIALITY**

These drawings and details are and shall remain the property of TT dotCom Sdn Bhd. Both are issued in strict confidence and shall not be reproduced, copied or used in any manner without specific written permission from the owner.

**LEGEND :-**

- = MDF ROOM
- = EXISTING PIT
- = BUILDING MANHOLE (BMH)
- = NEW TIME MANHOLE
- = PROJECT TIME MH BY OTHER
- = EXISTING TIME MANHOLE (EXTG TMH)
- = PIT
- = EXISTING TMB MANHOLE
- = 2W MT
- = RIGHT OF WAY
- = EXISTING DUCT ROUTE
- = WORK AREA
- = GRASS AREA
- = TRAFFIC FLOW
- = HORIZONTAL DIRECTIONAL DRILLING
- = OPEN CUT
- = MICRO TRENCHING
- = ROAD BOUNDARY

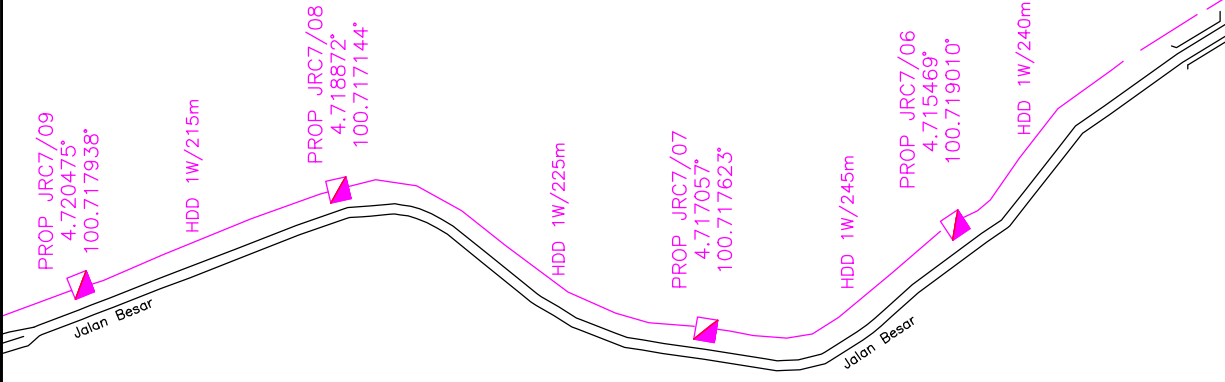

PROJECT TITLE:

KUALA KURAU

DRAWING TITLE:

AS BUILT DRAWING – KUALA KURAU

DRAWING SCALE:

N.T.S

DRAWING UNITS:

METER

PREPARED BY:

NUR HIDAYAH

INITIAL & DATE:

25/06/2025

DESIGNED BY:

PURNAMA SOLUTION

INITIAL & DATE:

25/06/2025

CHECKED BY:

INDRAN

INITIAL & DATE:

25/06/2025

APPROVED BY:

TT DOTCOM SDN BHD

INITIAL & DATE:

25/06/2025



TT dotcom Sdn Bhd 197901008085 (52371-A)  
 No. 14, Jalan Majistret U1/26,  
 HICOM Glenmarie Industrial Park,  
 40150 Shah Alam,  
 Selangor Darul Ehsan, Malaysia.  
 Tel: +60 3 5032 6000 Website: www.time.com.my

PURNAMA SOLUTION (M) SDN BHD  
 (568408-P)

S-09-03, First Subang, Jalan SS15/4G,  
 47500 Subang Jaya, Selangor




DRAWING NO: TTDC/COV/ANGSUN LUMAYAN/01\_1-01 SHEET NO: 1/1

**CONFIDENTIALITY**

These drawings and details are and shall remain the property of TT dotCom Sdn Bhd. Both are issued in strict confidence and shall not be reproduced, copied or used in any manner without specific written permission from the owner.

**LEGEND :-**

- = MDF ROOM
- = EXISTING PIT
- = BUILDING MANHOLE (BMH)
- = NEW TIME MANHOLE
- = PROJECT TIME MH BY OTHER
- = EXISTING TIME MANHOLE (EXTG TMH)
- = PIT
- = EXISTING TMB MANHOLE
- = 2W MT
- = RIGHT OF WAY
- = EXISTING DUCT ROUTE
- = WORK AREA
- = GRASS AREA
- = TRAFFIC FLOW
- = HORIZONTAL DIRECTIONAL DRILLING
- = OPEN CUT
- = MICRO TRENCHING
- = ROAD BOUNDARY

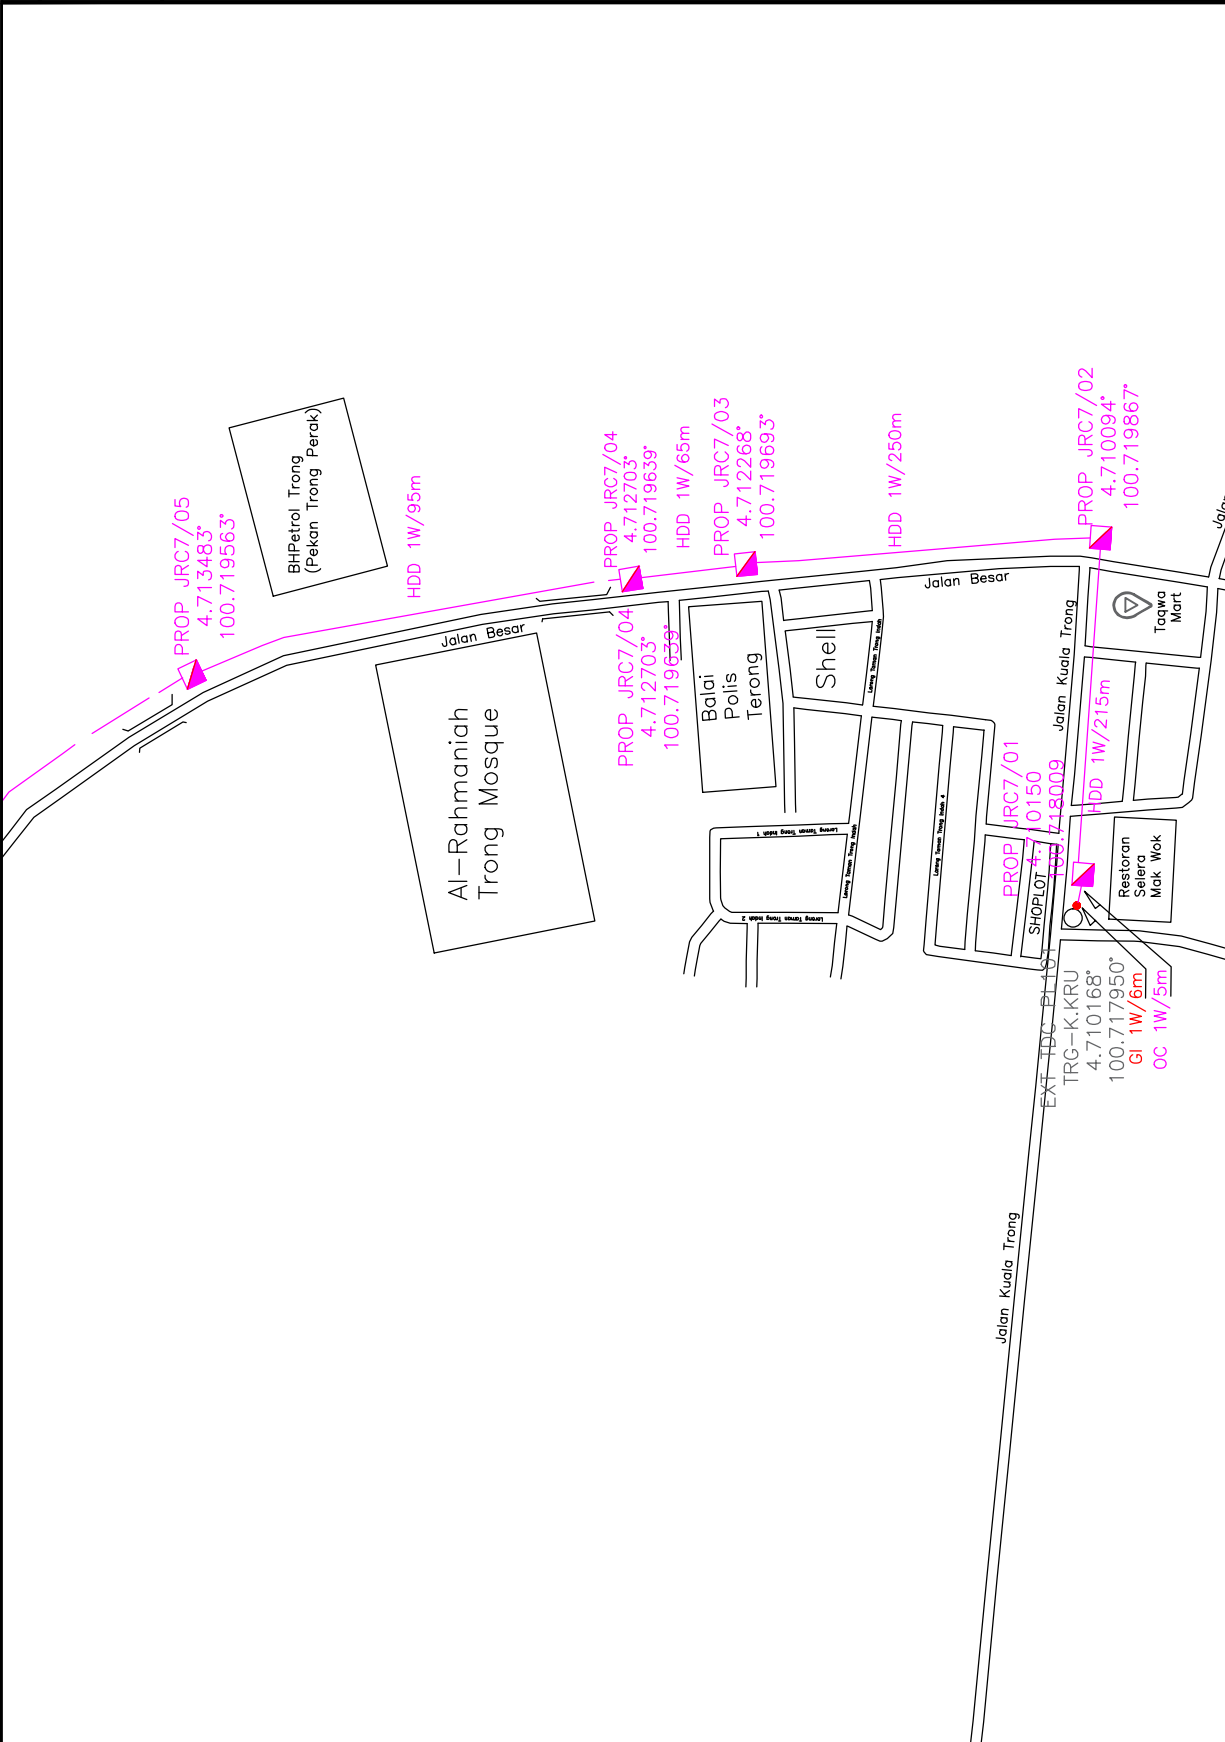

DRAWING SCALE:	N.T.S	DRAWING UNITS:	METER
PREPARED BY:	NUR HIDAYAH	INITIAL & DATE:	25/06/2025
DESIGNED BY:	PURNAMA SOLUTION	INITIAL & DATE:	25/06/2025
CHECKED BY:	INDRAN	INITIAL & DATE:	25/06/2025
APPROVED BY:	TT DOTCOM SDN BHD	INITIAL & DATE:	25/06/2025

PROJECT TITLE:	KUALA KURAU
DRAWING TITLE:	AS BUILT DRAWING – KUALA KURAU
DRAWING NO:	TTDC/COV/ANGGUN LUMAYAN/01_1-01
SHEET NO:	1/1

TT dotcom Sdn Bhd 197901008085 (52371-A)  
 No. 14, Jalan Majistret U1/26,  
 HICOM Glenmarie Industrial Park,  
 40150 Shah Alam,  
 Selangor Darul Ehsan, Malaysia.  
 Tel: +60 3 5032 6000 Website: www.time.com.my

**PURNAMA SOLUTION (M) SDN BHD**  
 (568408-P)  
 S-09-03, First Subang, Jalan SS15/4G,  
 47500 Subang Jaya, Selangor



**5.3 Drawing – SLD 144C**

**REFER TO NEXT SLIDE**

**CONFIDENTIALITY**

These drawings and details are and shall remain the property of TT dotCom Sdn Bhd. Both are issued in strict confidence and shall not be reproduced, copied or used in any manner without specific written permission from the owner.

**LEGEND :-**

- = MDF ROOM
- = EXISTING PIT
- = BUILDING MANHOLE (BMH)
- = NEW TIME MANHOLE
- = PROJECT TIME MH BY OTHER
- = EXISTING TIME MANHOLE (EXTG TMH)
- = PIT
- = EXISTING TMB MANHOLE
- = 2W MT
- = RIGHT OF WAY
- = EXISTING DUCT ROUTE
- = WORK AREA
- = GRASS AREA
- = TRAFFIC FLOW
- = HORIZONTAL DIRECTIONAL DRILLING
- = HDD
- = OC
- = MT
- = MICRO TRENCHING
- = ROAD BOUNDARY



**NOTE:**  
TOTAL CABLE 144C CABLE PULLING = 3382m

EXT TDC PL101  
TRG-K.KRU  
4.710168°  
100.717950°

DRAWING SCALE:	N.T.S	DRAWING UNITS:	METER
PREPARED BY:	NUR HIDAYAH	INITIAL & DATE:	25/06/2025
DESIGNED BY:	PURNAMA SOLUTION	INITIAL & DATE:	25/06/2025
CHECKED BY:	INDRAN	INITIAL & DATE:	25/06/2025
APPROVED BY:	TT DOTCOM SDN BHD	INITIAL & DATE:	25/06/2025

PROJECT TITLE:	KUALA KURAU
DRAWING TITLE:	STRAIGHT LINE DRAWING – KUALA KURAU
DRAWING NO:	TTDC/COV/ANGGUN LUMAYAN/01_1-01
SHEET NO:	1/1

TT dotcom Sdn Bhd 197901008085 (52371-A)  
No. 14, Jalan Majistret U1/26,  
HICOM Glenmarie Industrial Park,  
40150 Shah Alam,  
Selangor Darul Ehsan, Malaysia.  
Tel: +60 3 5032 6000 Website: www.time.com.my


**PURNAMA SOLUTION (M) SDN BHD**  
(568408-P)

S-09-03, First Subang, Jalan SS15/4C,  
47500 Subang Jaya, Selangor

**SOLUTION**

6. APPENDIX A

6.1 Site Photo

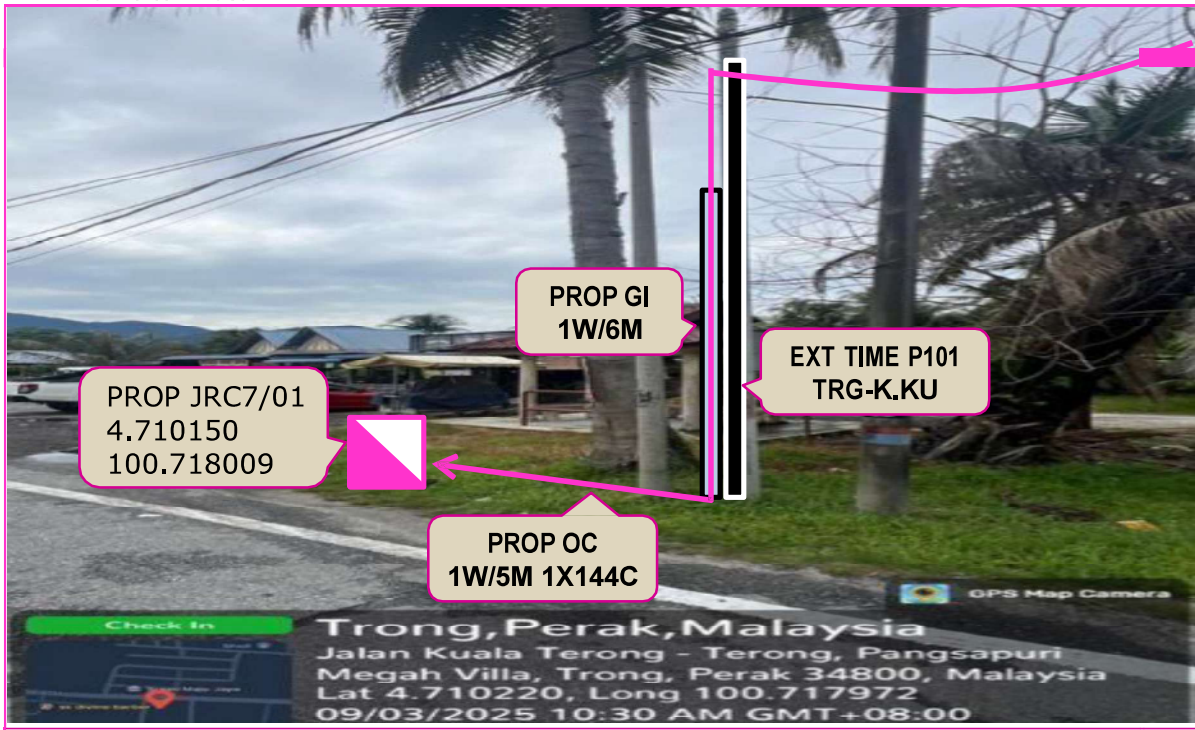

PROPOSED START CIVIL \*TAP INFRA\* EXT TIME P101 AT JALAN KUALA TRONG




PROP 144C CABLE ROUTING VIA PROP JRC7/01 AT JALAN KUALA TRONG (ROADSIDE)



PROP 144C CABLE ROUTING VIA PROP JRC7/02 AT JALAN BESAR (ROADSIDE)



PROP 144C CABLE ROUTING VIA PROP JRC7/03 AT JALAN BESAR (ROADSIDE)

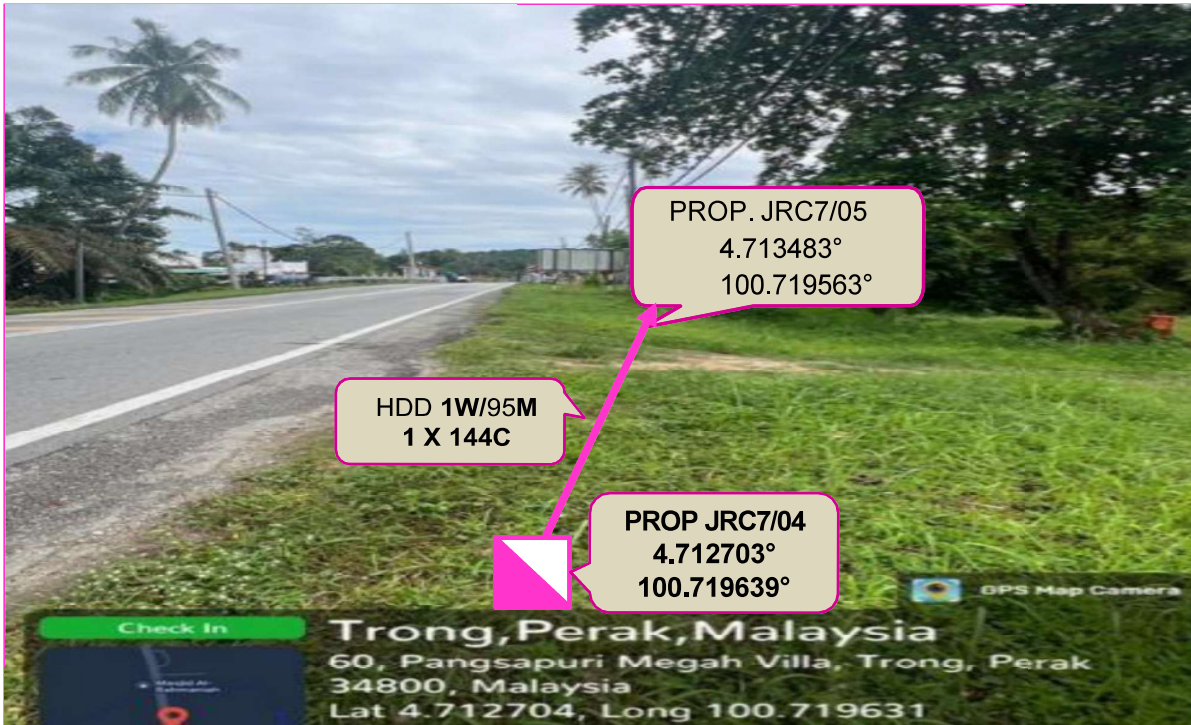


PROP 144C CABLE ROUTING VIA PROP JRC7/04 AT JALAN BESAR (ROADSIDE)



PROP 144C CABLE ROUTING VIA PROP JRC7/05 AT JALAN BESAR (ROADSIDE)




PROP 144C CABLE ROUTING VIA PROP JRC7/06 AT JALAN BESAR (ROADSIDE)

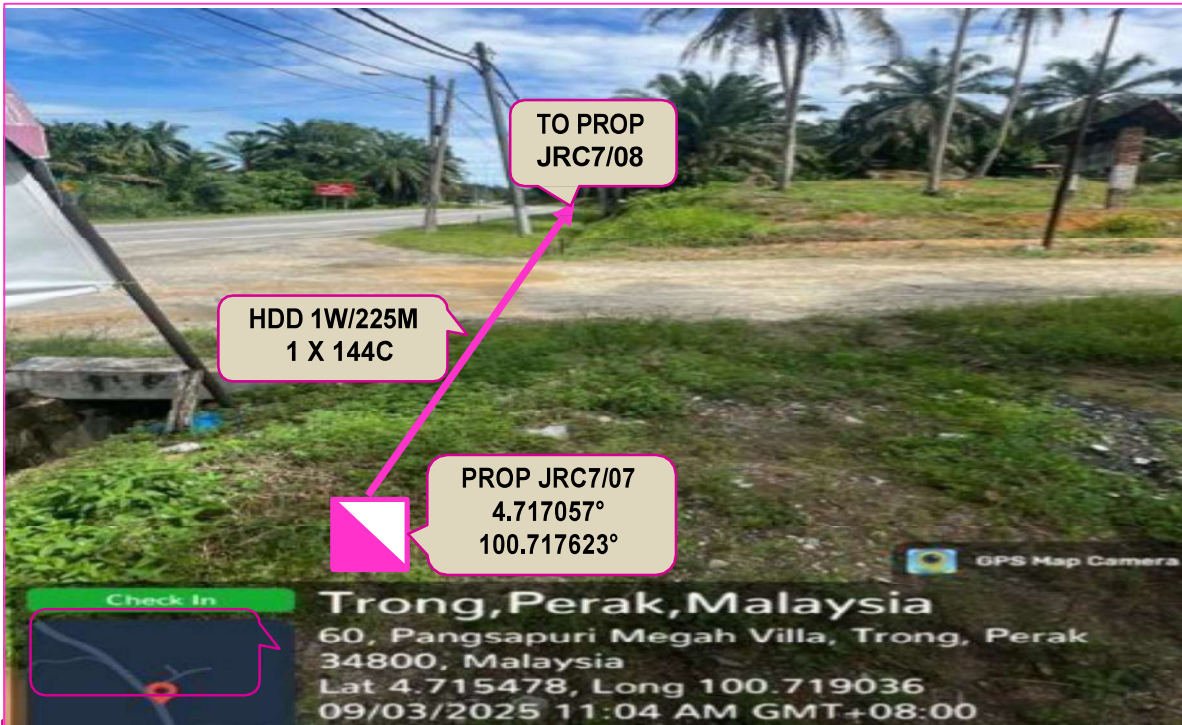

PROP 144C CABLE ROUTING VIA PROP JRC7/07 AT JALAN BESAR (ROADSIDE)



PROP 144C CABLE ROUTING VIA PROP JRC7/08 AT JALAN BESAR (ROADSIDE)

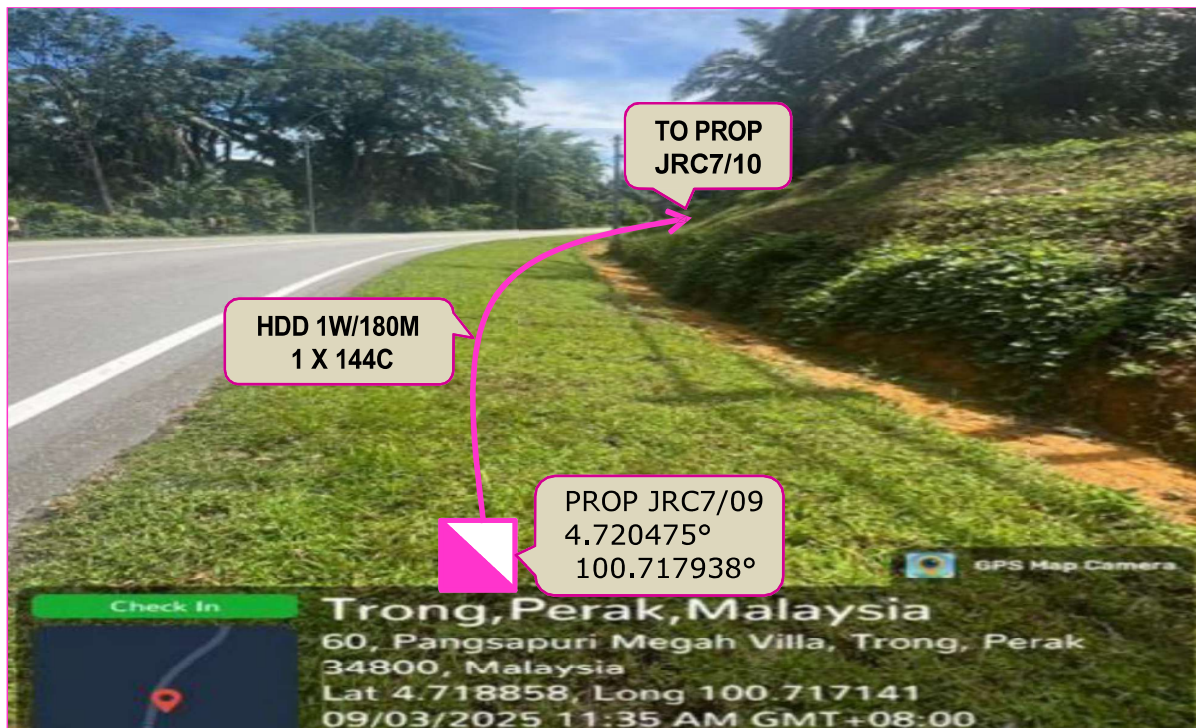


PROP 144C CABLE ROUTING VIA PROP JRC7/09 AT JALAN BESAR (ROADSIDE)



PROP 144C CABLE ROUTING VIA PROP JRC7/10 AT JALAN BESAR (ROADSIDE)



PROP 144C CABLE ROUTING VIA PROP JRC7/11 AT JALAN BESAR (ROADSIDE)

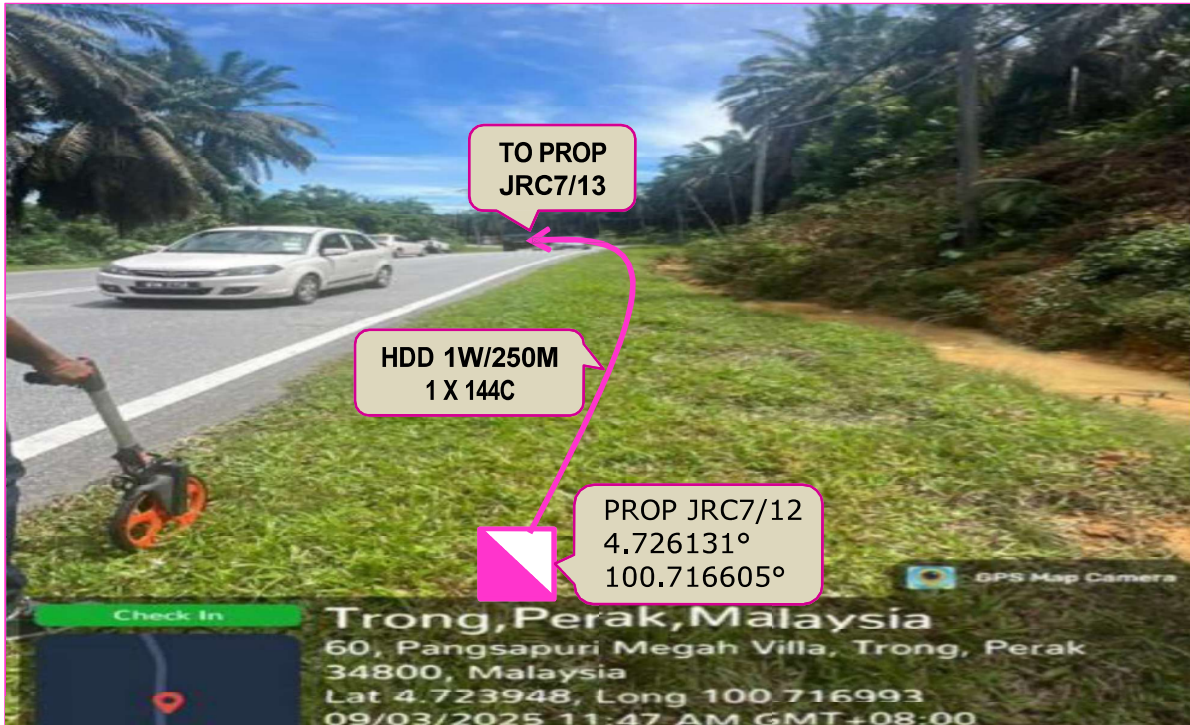

PROP 144C CABLE ROUTING VIA PROP JRC7/12 AT JALAN BESAR (ROADSIDE)



PROP 144C CABLE ROUTING VIA PROP JRC7/13 AT JALAN BESAR (ROADSIDE)



PROP 144C CABLE ROUTING VIA PROP JRC7/14 AT JALAN BESAR (ROADSIDE)



PROP 144C CABLE ROUTING VIA PROP JRC7/15 AT JALAN BESAR (ROADSIDE)



PROP 144C CABLE ROUTING VIA PROP JRC7/16 AT JALAN BESAR (ROADSIDE)



PROP 144C CABLE ROUTING VIA PROP JRC7/17 AT JALAN BESAR (ROADSIDE)



## 6.2 Existing and Propose Manhole

No.	MH Number	Coordinate (Lat)	Coordinate (Long)
1	EXT TDC POLE 101 TRG-K.KRU (START POINT)	4.710168°	100.717950°
2	PROP JRC7/01	4.710150°	100.718009°
3	PROP JRC7/02	4.710094°	100.719867°
4	PROP JRC7/03	4.712268°	100.719693°
5	PROP JRC7/04	4.712703°	100.719639°
6	PROP JRC7/05	4.713483°	100.719563°
7	PROP JRC7/06	4.715469°	100.719010°
8	PROP JRC7/07	4.717057°	100.717623°
9	PROP JRC7/08	4.718872°	100.717144°
10	PROP JRC7/09	4.720475°	100.717938°
11	PROP JRC7/10	4.721895°	100.717395°
12	PROP JRC7/11	4.724197°	100.717114°
13	PROP JRC7/12	4.726131°	100.716605°
14	PROP JRC7/13	4.728220°	100.715957°
15	PROP JRC7/14	4.730215°	100.715538°
16	PROP JRC7/15	4.731855°	100.714837°
17	PROP JRC7/16	4.733052°	100.713862°
18	PROP JRC7/17	4.734085°	100.713263°
19	EXT TDC POLE 136 TRG-K.KRU (END POINT)		